	Code	Weight [kg]	Tollerance [kg]
A	PATCH PANEL 1	1,5	0,005
B	PATCH PANEL 2	1	0,005
C	NETPROBE CONNECT	12	0,3
D	MTB-R19-F	14,4	0,3
E	HTB-R19-F	17,4	0,3
F	STB-R19-F	8	0,3
G	PC 1	12,5	0,3
H	IISU	17	NA
H	CAP 1	0,13	0,3
L	UPS 9PX SERIES 6k	71	NA
M	BATTERY PACK 1	59	NA
N	BATTERY PACK 2	59	NA
O	BATTERY PACK 3	59	NA
P	SOCKET GROUP	2,2	0,005
Q	MATRIX KVM	1,2	NA
R	CB PANEL	2,5	NA
S	UPS GUARDIAN	0,7	0,005
T	ACC WI-FI	1,5	NA

FRONTAL VIEW

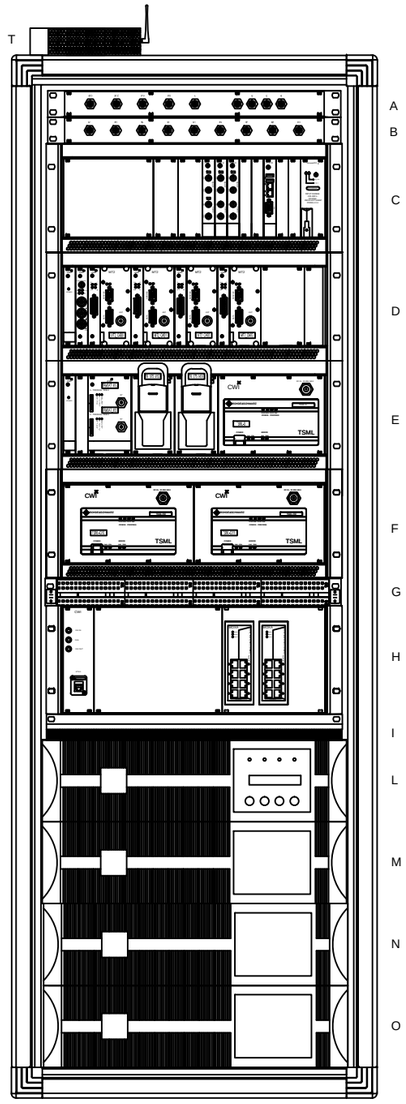

BACK VIEW

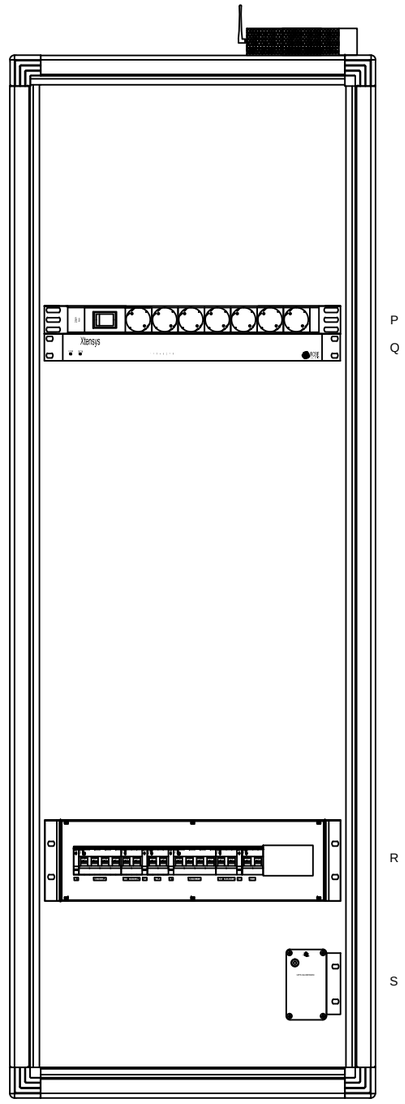

Rev.	Description	Date	Designer	Controller
6				
5				
4				
3				
2	As-built	21/11/14	Pavan	Cotroneo
1	Acces point WiFi and NetProbe connect added	28/10/14	Pavan	Cotroneo

Comtest Wireless
Via Orvieto 19, Torino ITALY

This document is property of CWI S.r.l. and, it could be not utilized without the authorization of this society.

Customer: KCC	Title: GSM-R Cabinet			
Customer order reference: /	Substitute of: EM-3-010-002_4	Date: 21/11/14	Designer: Pavan	Controller: Cotroneo
Our order reference: 31-2014-KCC-HU ex 010	Sheet 1 of 1 Overall/ref.: ...		Design code: EM-31-2014-001_2	Rev.: 2

Scale: 1:10

ISO 7200 R. 2